




- Note:
1. Builder to confirm all dimensions and roof pitch prior to construction.
 2. All construction to conform with Building Code of Australia & AS1684.3.
 3. Unless otherwise indicated all timber sizes calculated in accordance with "Hyne version 7.5.8.0"
 4. Alternative timber sizes and grades as per Frame Manufacturer's details.
 5. Termite control as per AS3660.1.
 6. All steel construction and bracing requirements as per Engineer's details.
 7. Concrete slab and footings, and tie downs as per Engineer's details.
 8. All details shown as for an "As Constructed" structure.

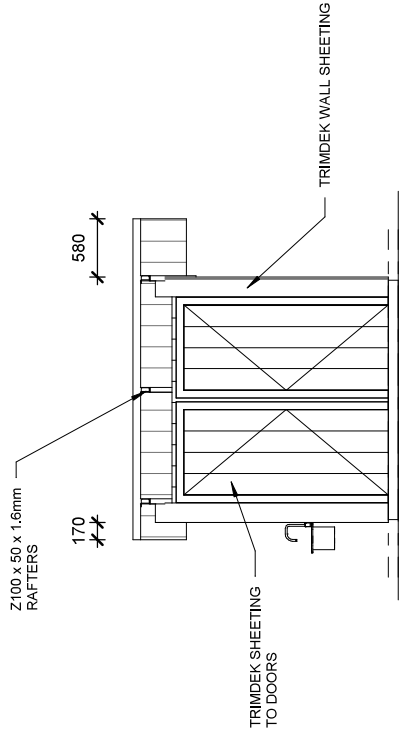


ELEVATION - 'C'

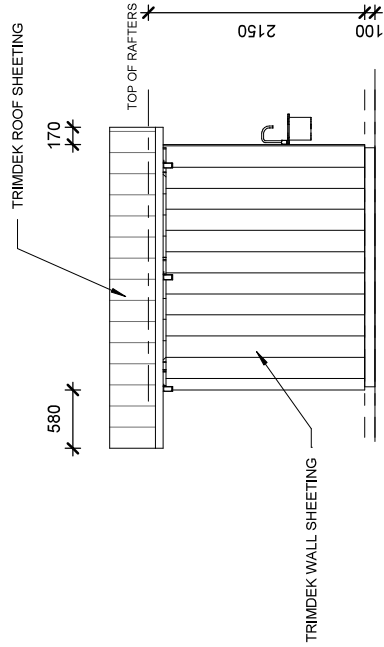

ELEVATION - 'A'

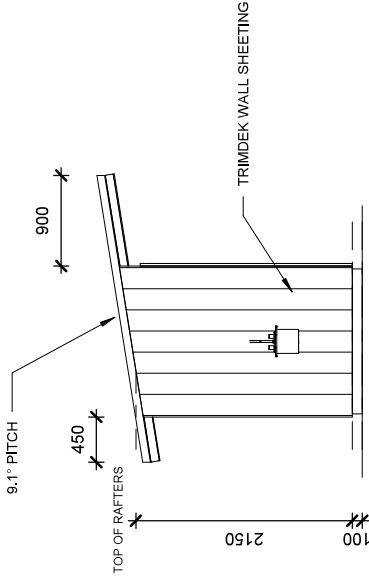

ELEVATION - 'D'

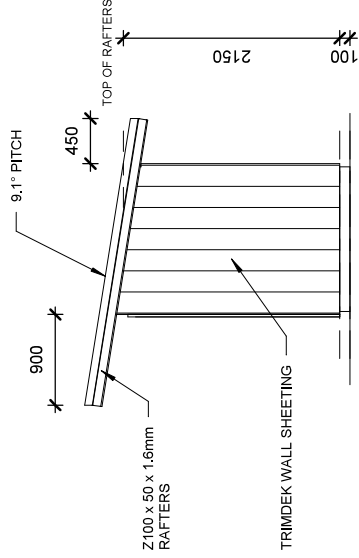

ELEVATION - 'B'

NOTE: DO NOT SCALE OFF DRAWING CAT C2

JOHN POULSEN BUILDING DESIGN

PO Box 2885
BUNDABERG Q 4670
Mob 0427 593 682
Email johnpoulsendesign@bigpond.com
BSA Licence No. 56962

Midskinrick Lodge & Camping Proposed Toilets No. 2

No.	Description	Date



ELEVATIONS

Project number	PD 2200
Date	21 May 2019
Drawn by	NJ Poulsen
Checked by	NJ Poulsen

FLOOR AREA
TOILETS
4.38 m²

Note:


1. Builder to confirm all dimensions and roof pitch prior to construction.
2. All construction to conform with Building Code of Australia & AS1684.3.
3. Unless otherwise indicated all timber sizes calculated in accordance with 'Hyne version 7.5.8.0"
4. Alternative timber sizes and grades as per Frame Manufacturer's details.
5. Termite control as per AS3660.1.
6. All steel construction and bracing requirements as per Engineer's details.
7. Concrete slab and footings, and tie downs as per Engineer's details.
8. All details shown as for an "As Constructed" structure.

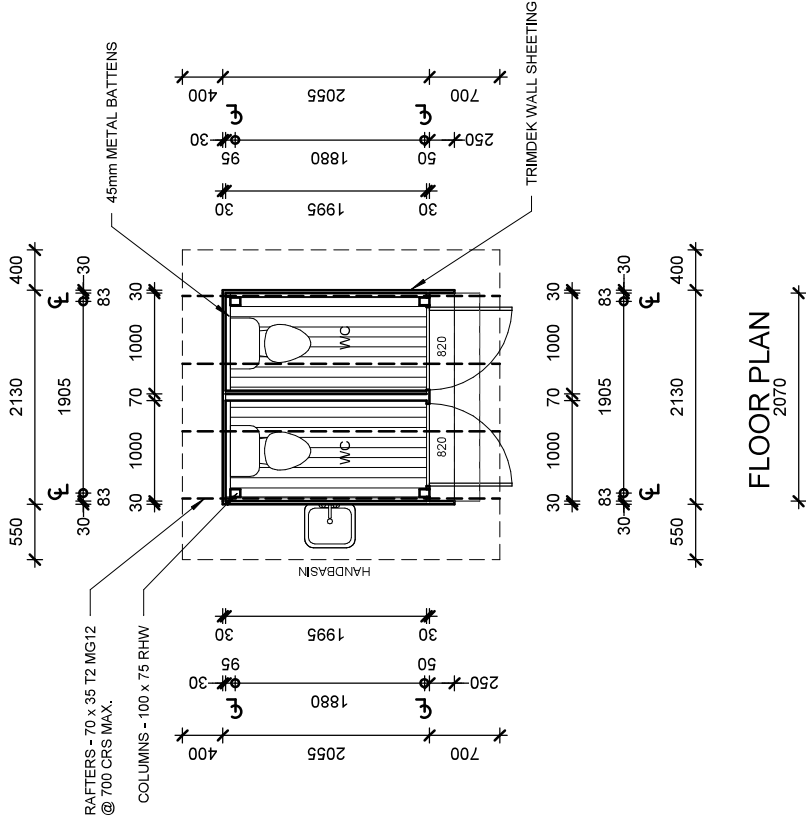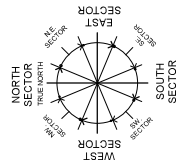

FLOOR PLAN
2070

FOR SITE PLAN DETAILS REFER TO PLAN No. PD2198
(John Poulsen Building Design)

NOTE: DO NOT SCALE OFF DRAWING CAT C2

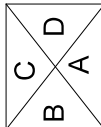

JOHN POULSEN BUILDING DESIGN

PO Box 2885
BUNDABERG Q 4670
Mob 0427 593 682
Email johnpoulsendesign@bigpond.com
BSA Licence No. 56962


Midskinrick Lodge & Camping Proposed Toilets No. 3

No.	Description	Date


FLOOR PLAN

Project number	PD 2201
Date	21 May 2019
Drawn by	NJ Poulsen
Checked by	NJ Poulsen


- Note:
1. Builder to confirm all dimensions and roof pitch prior to construction.
 2. All construction to conform with Building Code of Australia & AS1684.3.
 3. Unless otherwise indicated all timber sizes calculated in accordance with "Hyne version 7.5.8.0"
 4. Alternative timber sizes and grades as per Frame Manufacturer's details.
 5. Termite control as per AS3660.1.
 6. All steel construction and bracing requirements as per Engineer's details.
 7. Concrete slab and footings, and tie downs as per Engineer's details.
 8. All details shown as for an "As Constructed" structure.

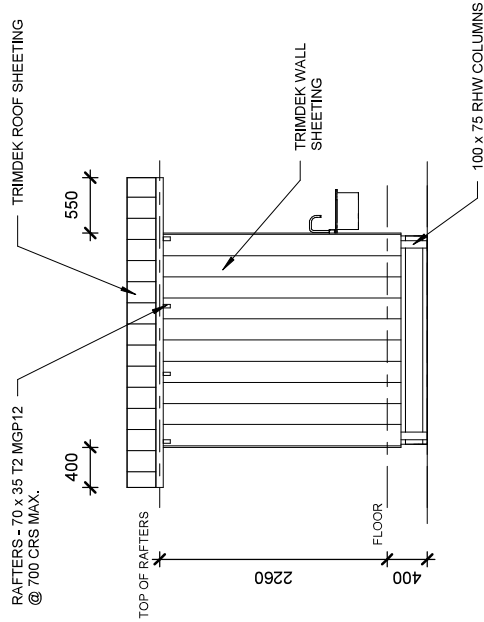


ELEVATION - 'C'

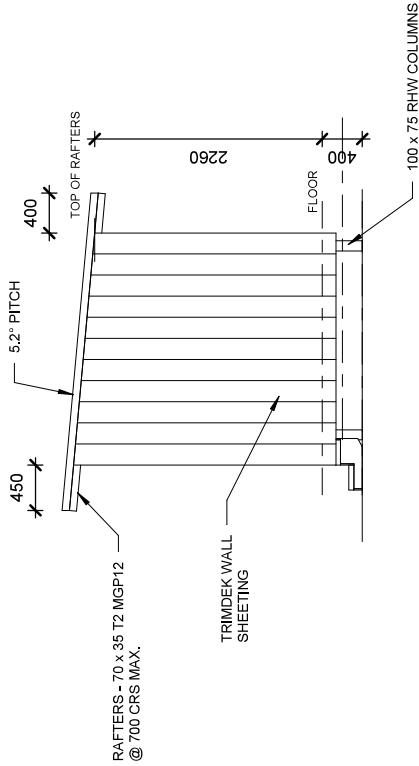

ELEVATION - 'D'

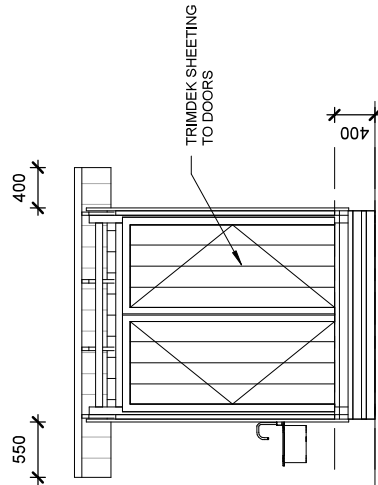

ELEVATION - 'A'

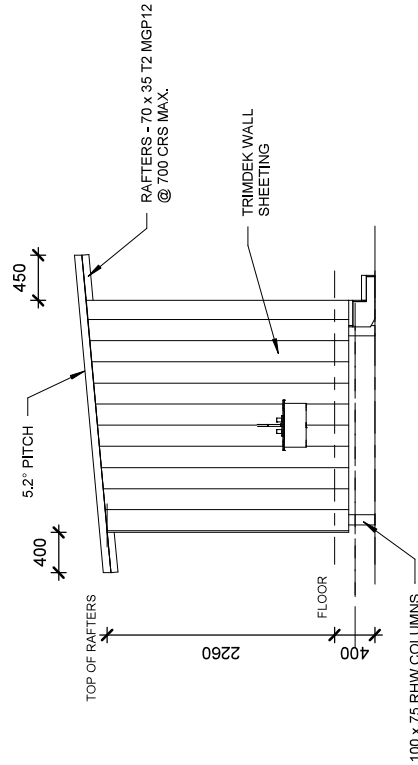

ELEVATION - 'B'

NOTE: DO NOT SCALE OFF DRAWING CAT C2

JOHN POULSEN BUILDING DESIGN

PO Box 2885
BUNDABERG Q 4670
Mob 0427 593 682
Email johnpoulsendesign@bigpond.com
BSA Licence No. 56962

Midskinrick Lodge & Camping
Proposed Toilets No. 3

No.	Description	Date


ELEVATIONS

Project number	PD 2201
Date	21 May 2019
Drawn by	NJ Poulsen
Checked by	NJ Poulsen


FLOOR AREA	
TOILET/ SHR	6.32 m ²
CONC. APRON	5.10 m ²
TOTAL AREA	11.42 m ²

Note:

1. Builder to confirm all dimensions and roof pitch prior to construction.
2. All construction to conform with Building Code of Australia & AS1684.3.
3. Unless otherwise indicated all timber sizes calculated in accordance with 'Hyne version 7.5.8.0"
4. Alternative timber sizes and grades as per Frame Manufacturer's details.
5. Termite control as per AS3660.1.
6. All steel construction and bracing requirements as per Engineer's details.
7. Concrete slab and footings, and tie downs as per Engineer's details.
8. All details shown as for an "As Constructed" structure.

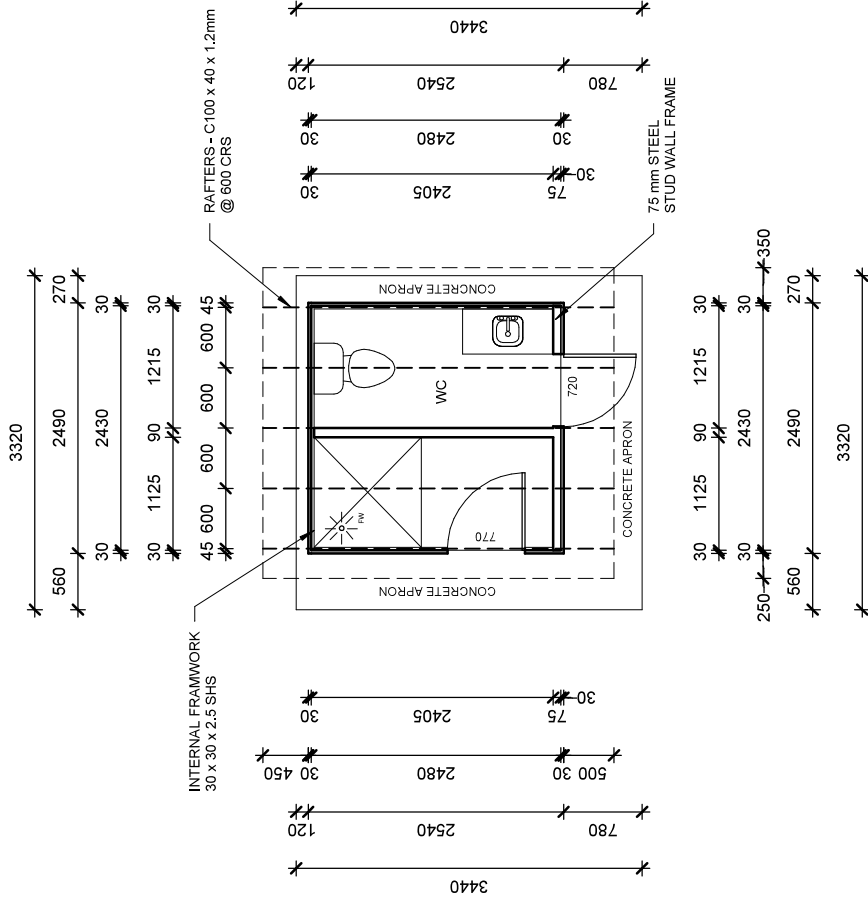

FLOOR PLAN

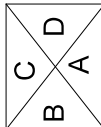

FOR SITE PLAN DETAILS REFER TO PLAN No. PD2198
(John Poulson Building Design)

NOTE: DO NOT SCALE OFF DRAWING CAT C2

JOHN POULSEN BUILDING DESIGN
PO Box 2885
BUNDABERG Q 4670
Mob 0427 593 682
Email johnpoulsondesign@bigpond.com
BSA Licence No. 56962

No.

Description

Date

Midskinrick Lodge & Camping
Proposed Toilet No. 4

Project number

PD 2202

Date

21 May 2019

Drawn by

NJ Poulson

Checked by

NJ Poulson

FLOOR PLAN


PAGE 2 OF 5

SHEET SIZE: A3


Scale

1 : 50


- Note:
1. Builder to confirm all dimensions and roof pitch prior to construction.
 2. All construction to conform with Building Code of Australia & AS1684.3.
 3. Unless otherwise indicated all timber sizes calculated in accordance with "Hyne version 7.5.8.0"
 4. Alternative timber sizes and grades as per Frame Manufacturer's details.
 5. Termite control as per AS3660.1.
 6. All steel construction and bracing requirements as per Engineer's details.
 7. Concrete slab and footings, and tie downs as per Engineer's details.
 8. All details shown as for an "As Constructed" structure.

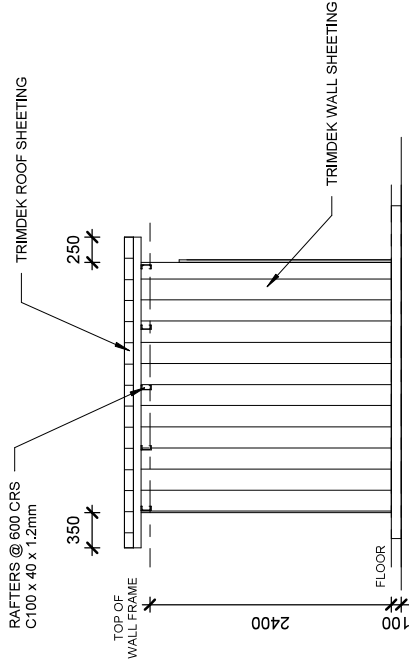


ELEVATION - 'C'

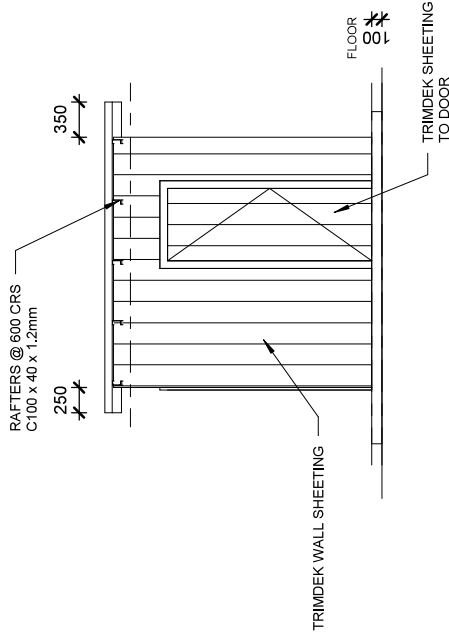

ELEVATION - 'A'

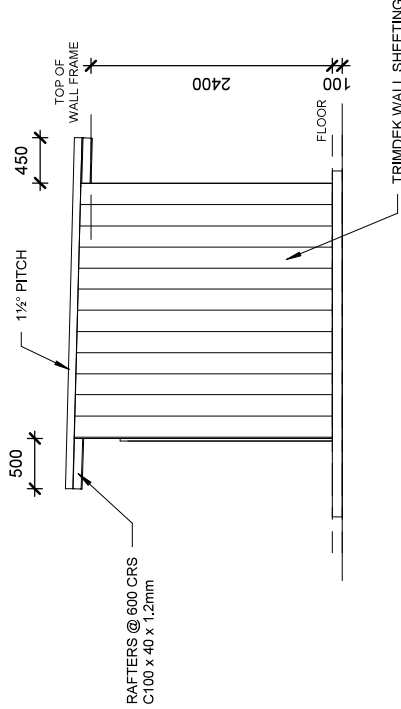

ELEVATION - 'D'

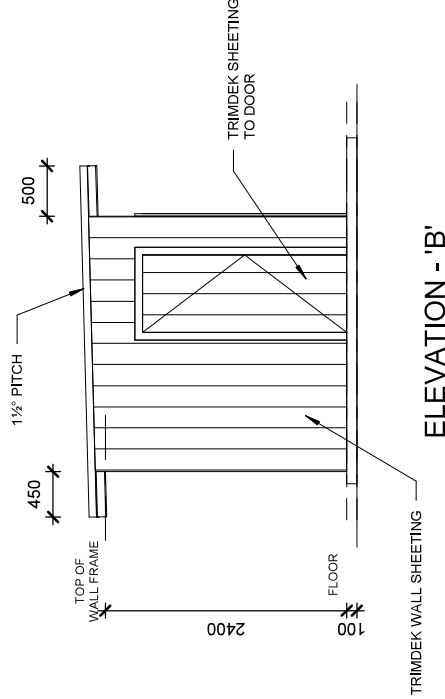

ELEVATION - 'B'

NOTE: DO NOT SCALE OFF DRAWING CAT C2

JOHN POULSEN BUILDING DESIGN

PO Box 2885
BUNDABERG Q 4670
Mob 0427 593 682
Email johnpoulsendesign@bigpond.com
BSA Licence No. 56962


Midskinrick Lodge & Camping

Proposed Toilet No. 4


ELEVATIONS

Project number	PD 2202	PAGE 3 OF 5	
Date	21 May 2019		
Drawn by	NJ Poulsen		
Checked by	NJ Poulsen		
SHEET SIZE: A3		Scale	1 : 50

FLOOR AREA	
TOILET/SHRS	6.64 m ²
LAUNDRY	2.82 m ²
TOTAL AREA	9.46 m²

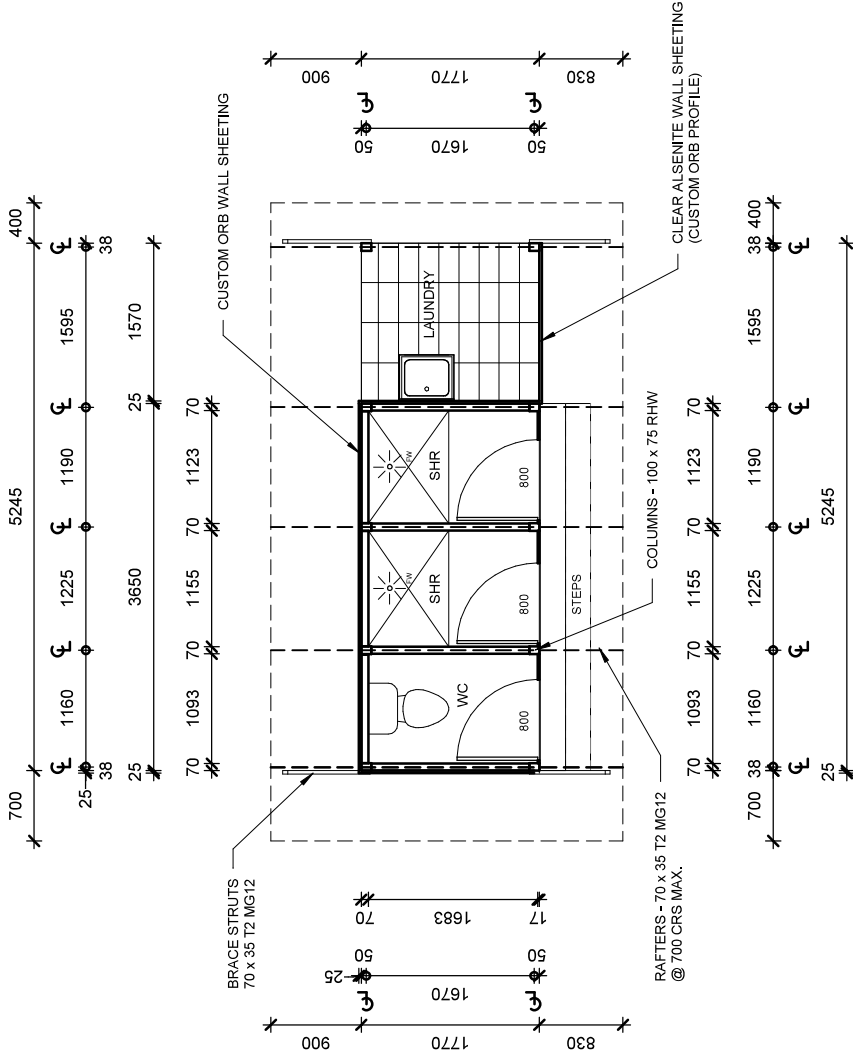

FLOOR PLAN

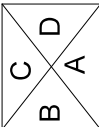

NOTE: DO NOT SCALE OFF DRAWING CAT C2

FOR SITE PLAN DETAILS REFER TO PLAN No. PD2198
(John Poulsen Building Design)

JOHN POULSEN BUILDING DESIGN

PO Box 2885
BUNDABERG Q 4670
Mob 0427 593 682
Email johnpoulsendesign@bigpond.com
BSA Licence No. 56962


Midskinrick Lodge & Camping
Proposed Toilet No. 5

No.	Description	Date


FLOOR PLAN

Project number	PD 2203	PAGE 2 OF 5
Date	21 May 2019	
Drawn by	NJ Poulsen	
Checked by	NJ Poulsen	
SHEET SIZE: A3		Scale 1 : 50


- Note:
1. Builder to confirm all dimensions and roof pitch prior to construction.
 2. All construction to conform with Building Code of Australia & AS1684.3.
 3. Unless otherwise indicated all timber sizes calculated in accordance with "Hyne version 7.5.8.0"
 4. Alternative timber sizes and grades as per Frame Manufacturer's details.
 5. Termite control as per AS3660.1.
 6. All steel construction and bracing requirements as per Engineer's details.
 7. Concrete slab and footings, and tie downs as per Engineer's details.
 8. All details shown as for an "As Constructed" structure.

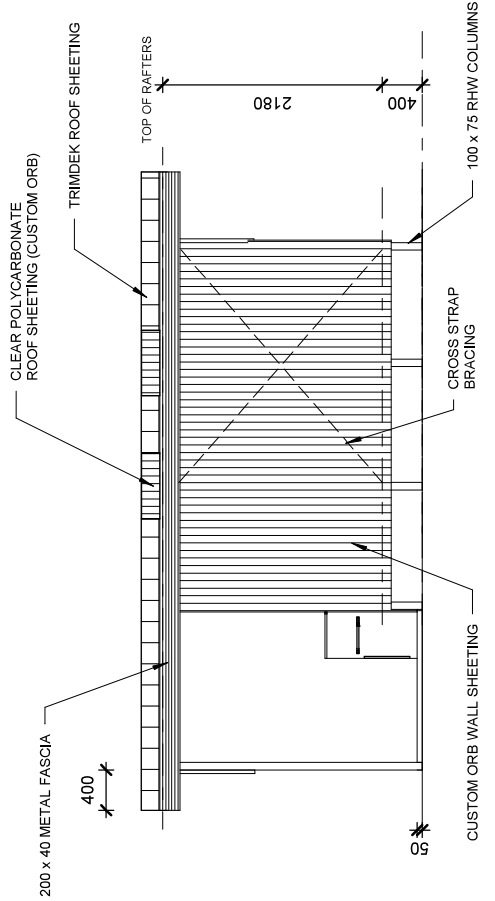


ELEVATION - 'C'

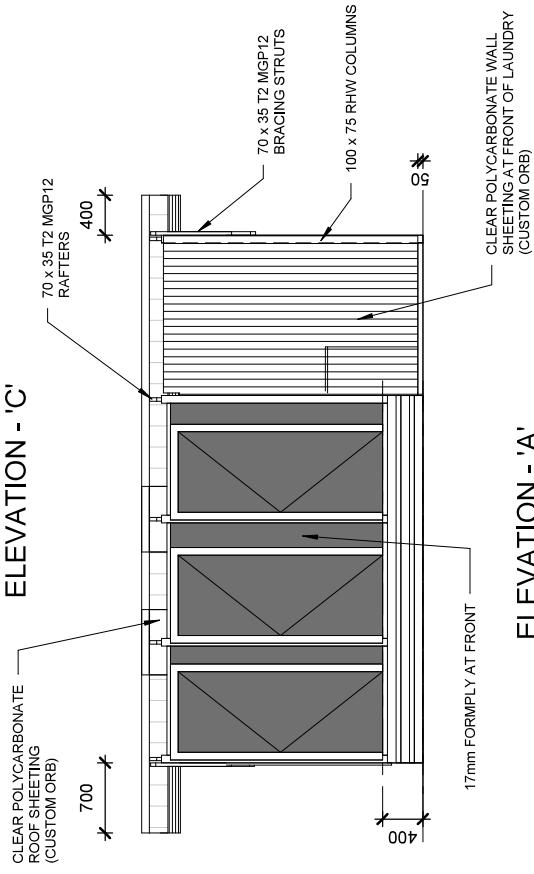

ELEVATION - 'A'

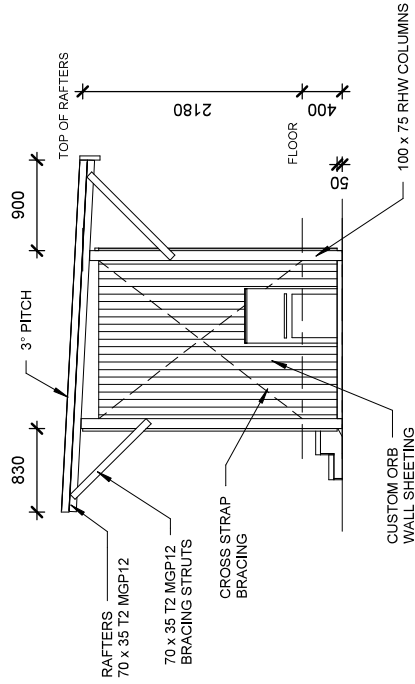

ELEVATION - 'D'

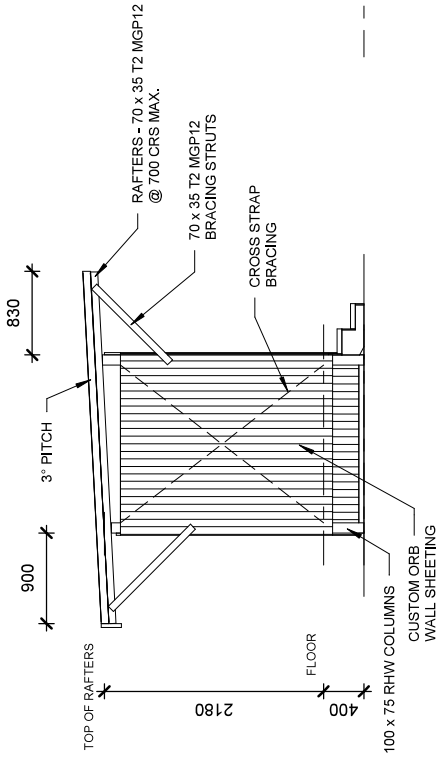

ELEVATION - 'B'

NOTE: DO NOT SCALE OFF DRAWING CAT C2

JOHN POULSEN BUILDING DESIGN

PO Box 2885
BUNDABERG Q 4670
Mob 0427 593 682
Email johnpoulsendesign@bigpond.com
BSA Licence No. 56962

Midskinrick Lodge & Camping Proposed Toilet No. 5

No.	Description	Date


ELEVATIONS

Project number	PD 2203
Date	21 May 2019
Drawn by	NJ Poulsen
Checked by	NJ Poulsen

FLOOR AREA	3.37 m ²
TOILET	

Note:

1. Builder to confirm all dimensions and roof pitch prior to construction.
2. All construction to conform with Building Code of Australia & AS1684.3.
3. Unless otherwise indicated all timber sizes calculated in accordance with "Hyne version 7.5.8.0"
4. Alternative timber sizes and grades as per Frame Manufacturer's details.
5. Termitc control as per AS3660.1.
6. All steel construction and bracing requirements as per Engineer's details.
7. Concrete slab and footings, and tie downs as per Engineer's details.

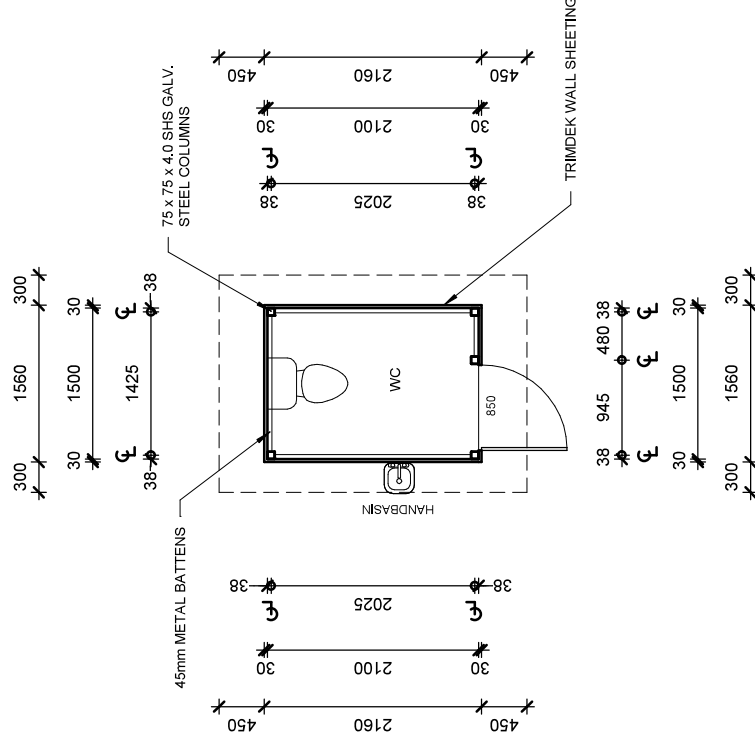

FLOOR PLAN

**FOR SITE PLAN DETAILS REFER TO PLAN No. PD2198
(John Poulsen Building Design)**

NOTE: DO NOT SCALE OFF DRAWING

JOHN POULSEN BUILDING DESIGN

PO Box 2885
BUNDABERG Q 4870


Mob 0407 593 692
Email johnpoulsendesign@bigpond.com
BSA Licence No. 56962

[illegible]


Midskinrick Lodge & Camping
Proposed Toilet No. 6

FLOOR PLAN			PAGE 2 OF 5	
Project number	PD 2204			
Date	21 May 2019			
Drawn by	NJ Poulsen			
Checked by	NJ Poulsen			
		SHEET SIZE: A3	Scale	1 : 50


- Note:
1. Builder to confirm all dimensions and roof pitch prior to construction.
 2. All construction to conform with Building Code of Australia & AS1684.3.
 3. Unless otherwise indicated all timber sizes calculated in accordance with "Hyne version 7.5.8.0"
 4. Alternative timber sizes and grades as per Frame Manufacturer's details.
 5. Termite control as per AS3660.1.
 6. All steel construction and bracing requirements as per Engineer's details.
 7. Concrete slab and footings, and tie downs as per Engineer's details.

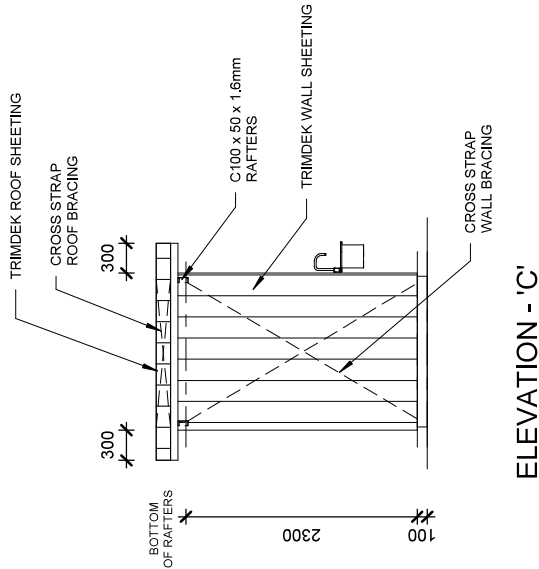


ELEVATION - 'C'

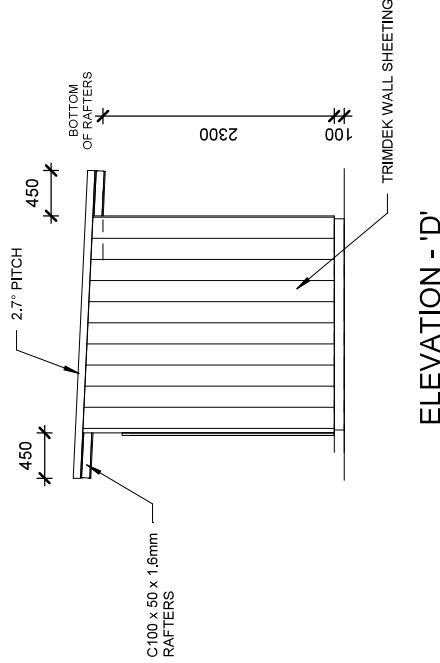

ELEVATION - 'D'

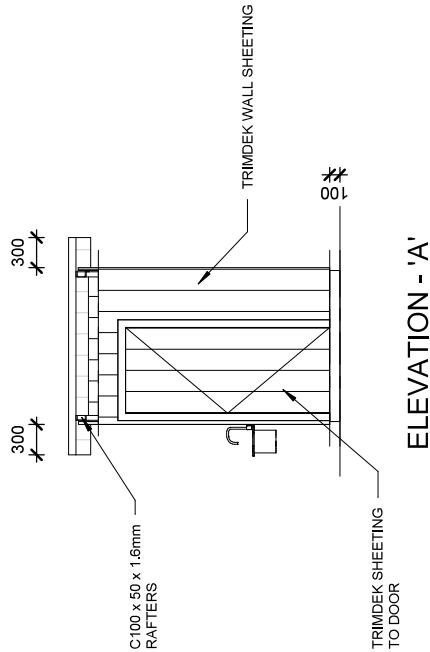

ELEVATION - 'A'

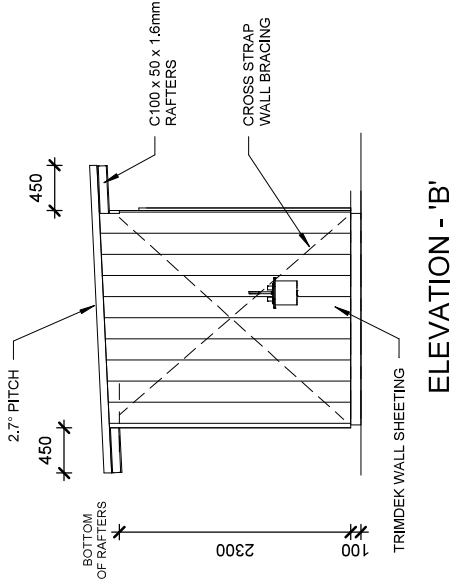

ELEVATION - 'B'

NOTE: DO NOT SCALE OFF DRAWING CAT C2

JOHN POULSEN BUILDING DESIGN

PO Box 2885
BUNDABERG Q 4670
Mob 0427 593 682
Email johnpoulsendesign@bigpond.com
BSA Licence No. 56962

Midskinrick Lodge & Camping Proposed Toilet No. 6

No.	Description	Date

ELEVATIONS

Project number	PD 2204
Date	21 May 2019
Drawn by	NJ Poulsen
Checked by	NJ Poulsen